

POLLACK SOUTHWINDS PLAZA

931 E ELLIOT RD, SUITE 116 & 117
 TEMPE, ARIZONA 85284

Notch
 ENTERPRISES LLC
 PLANNING - DESIGN - DRAFTING
 1540 E Maryland Ave #101
 Phoenix, Arizona 85014
 PH: 602.264.5454 FAX: 602.264.5411

POLLACK SOUTHWINDS PLAZA
 AS-BUILT & PROPOSED SUITE LAYOUT


931 EAST ELLIOT ROAD SUITE 116 & 117
 TEMPE AZ

SHEET TITLE:
 FLOOR PLAN &
 ELEVATION


DRAWN BY: **CF**
 CHECKED BY: **DLG**
 DATE: **10/01/2012**
 REVISION:
 ▲
 ▲

12-66


A1

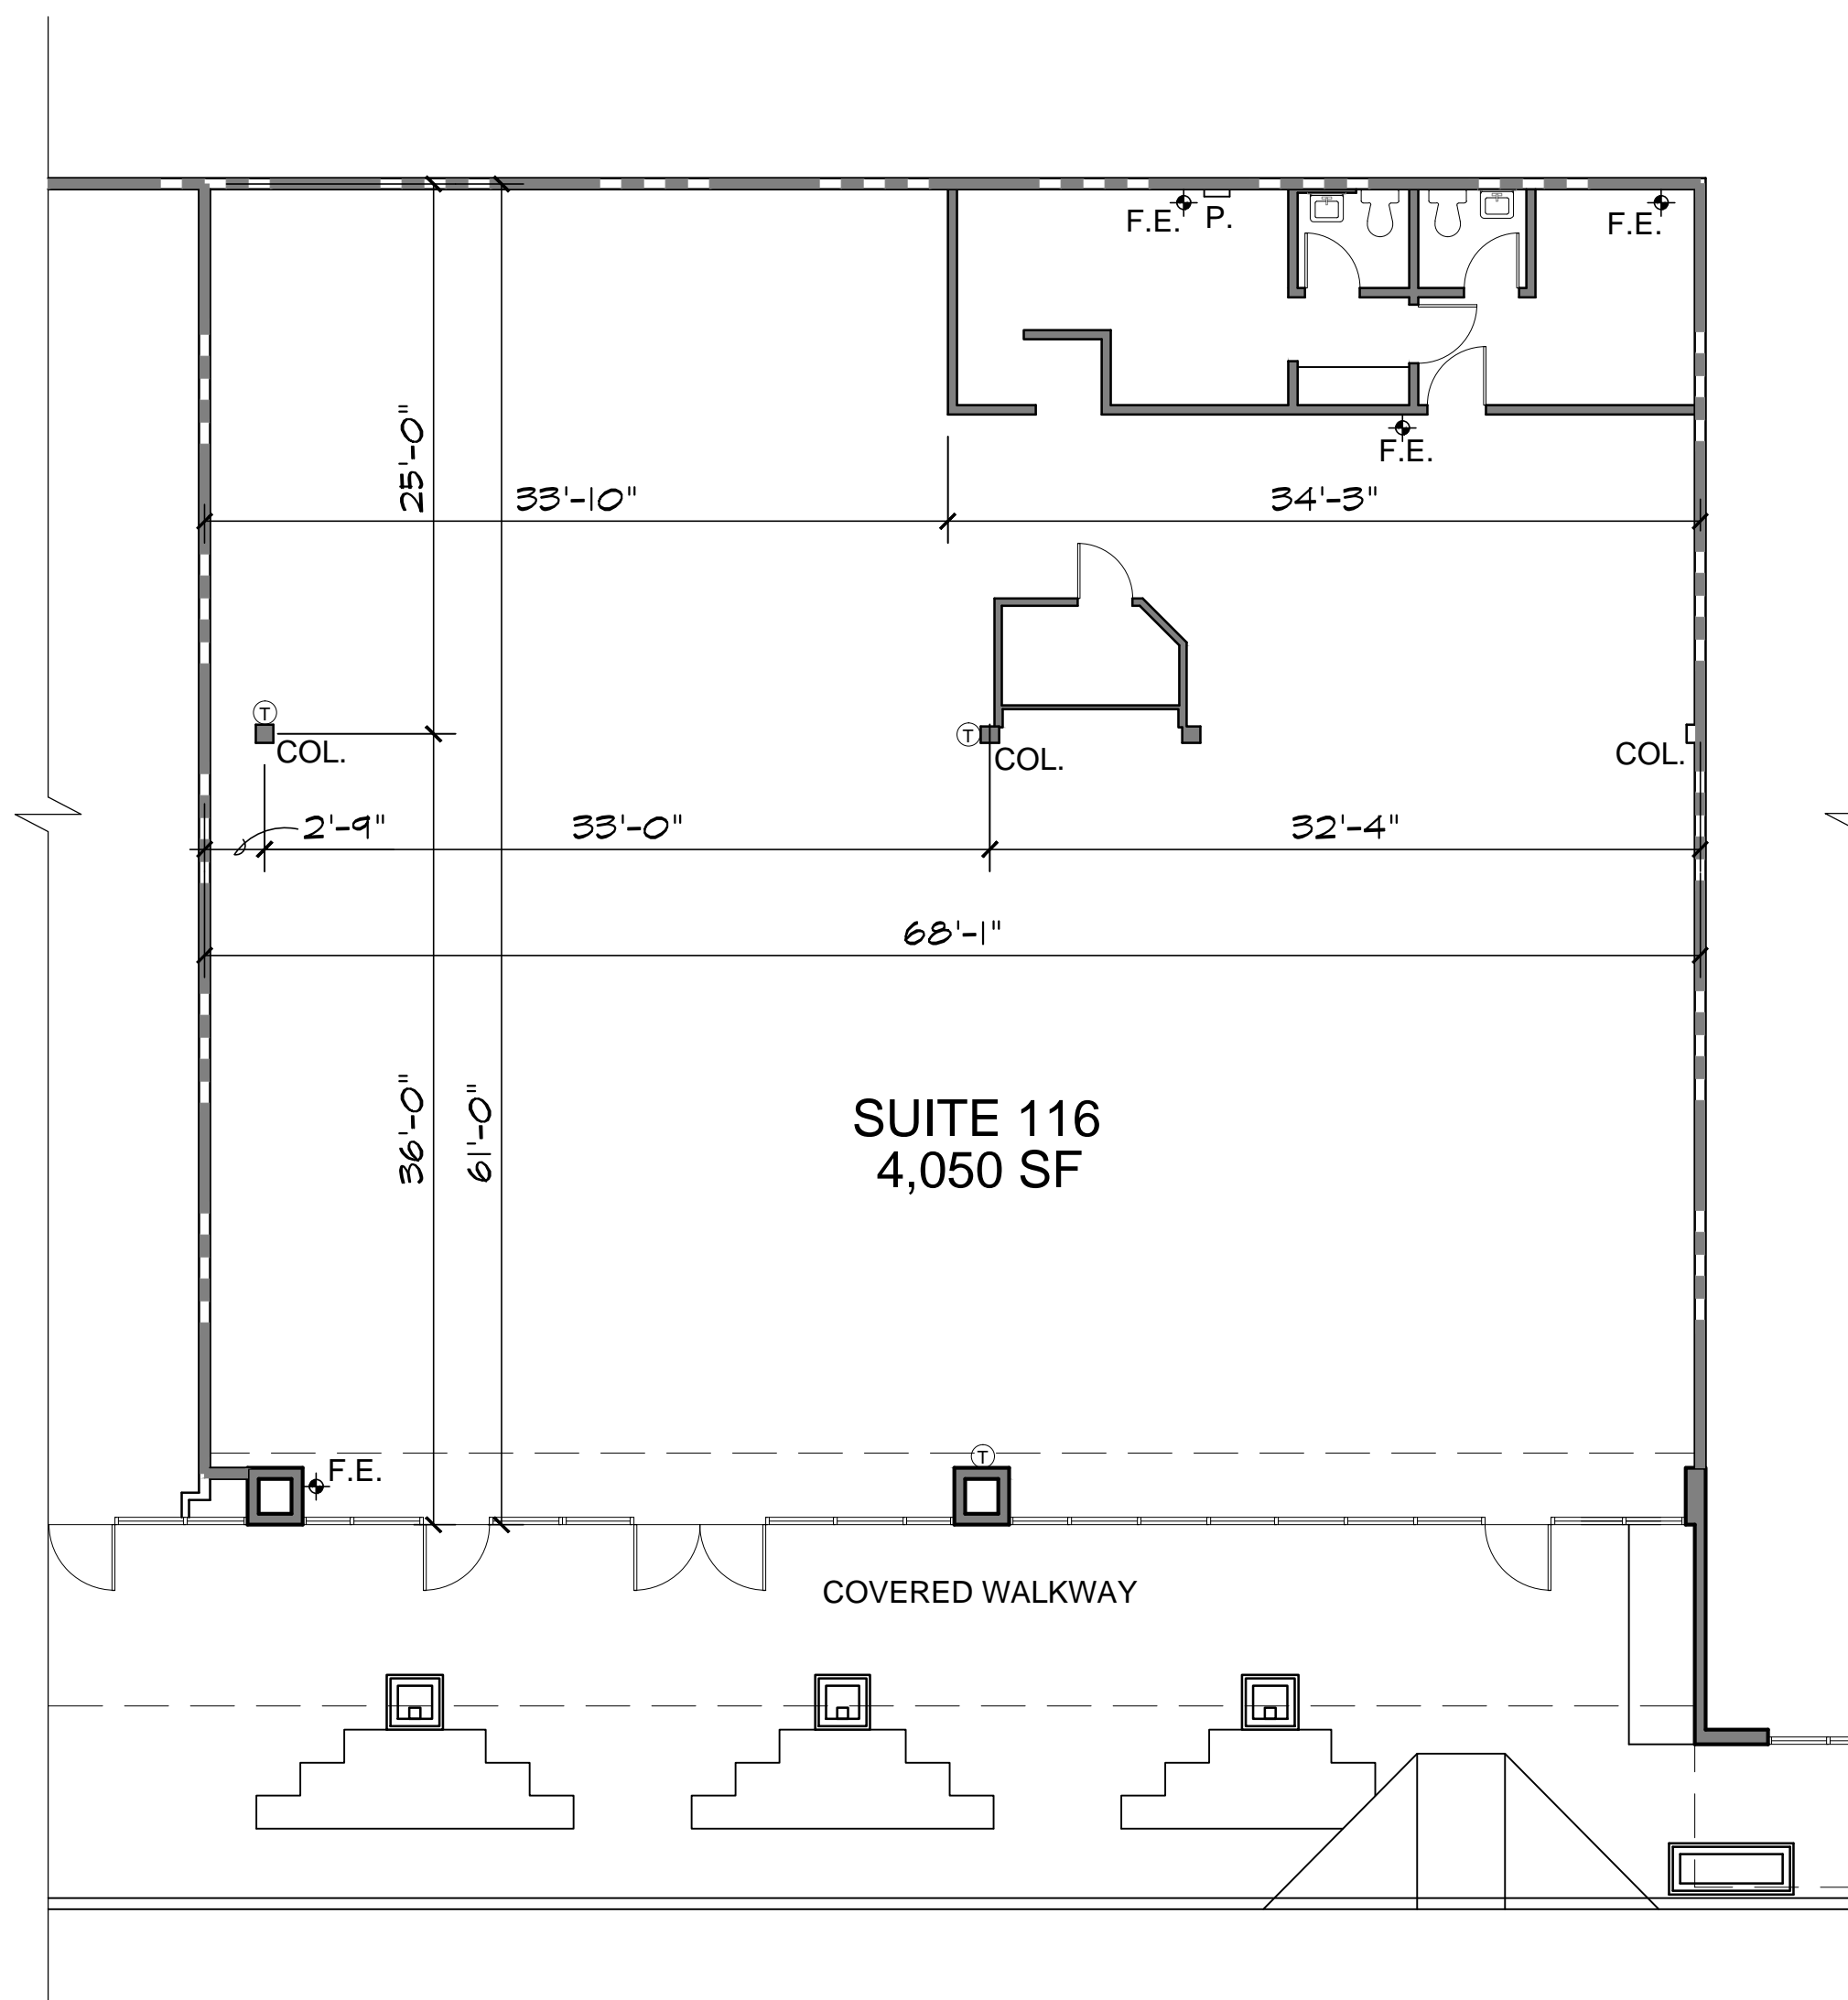

AS-BUILT FLOOR PLAN
 1/8" = 1'-0"

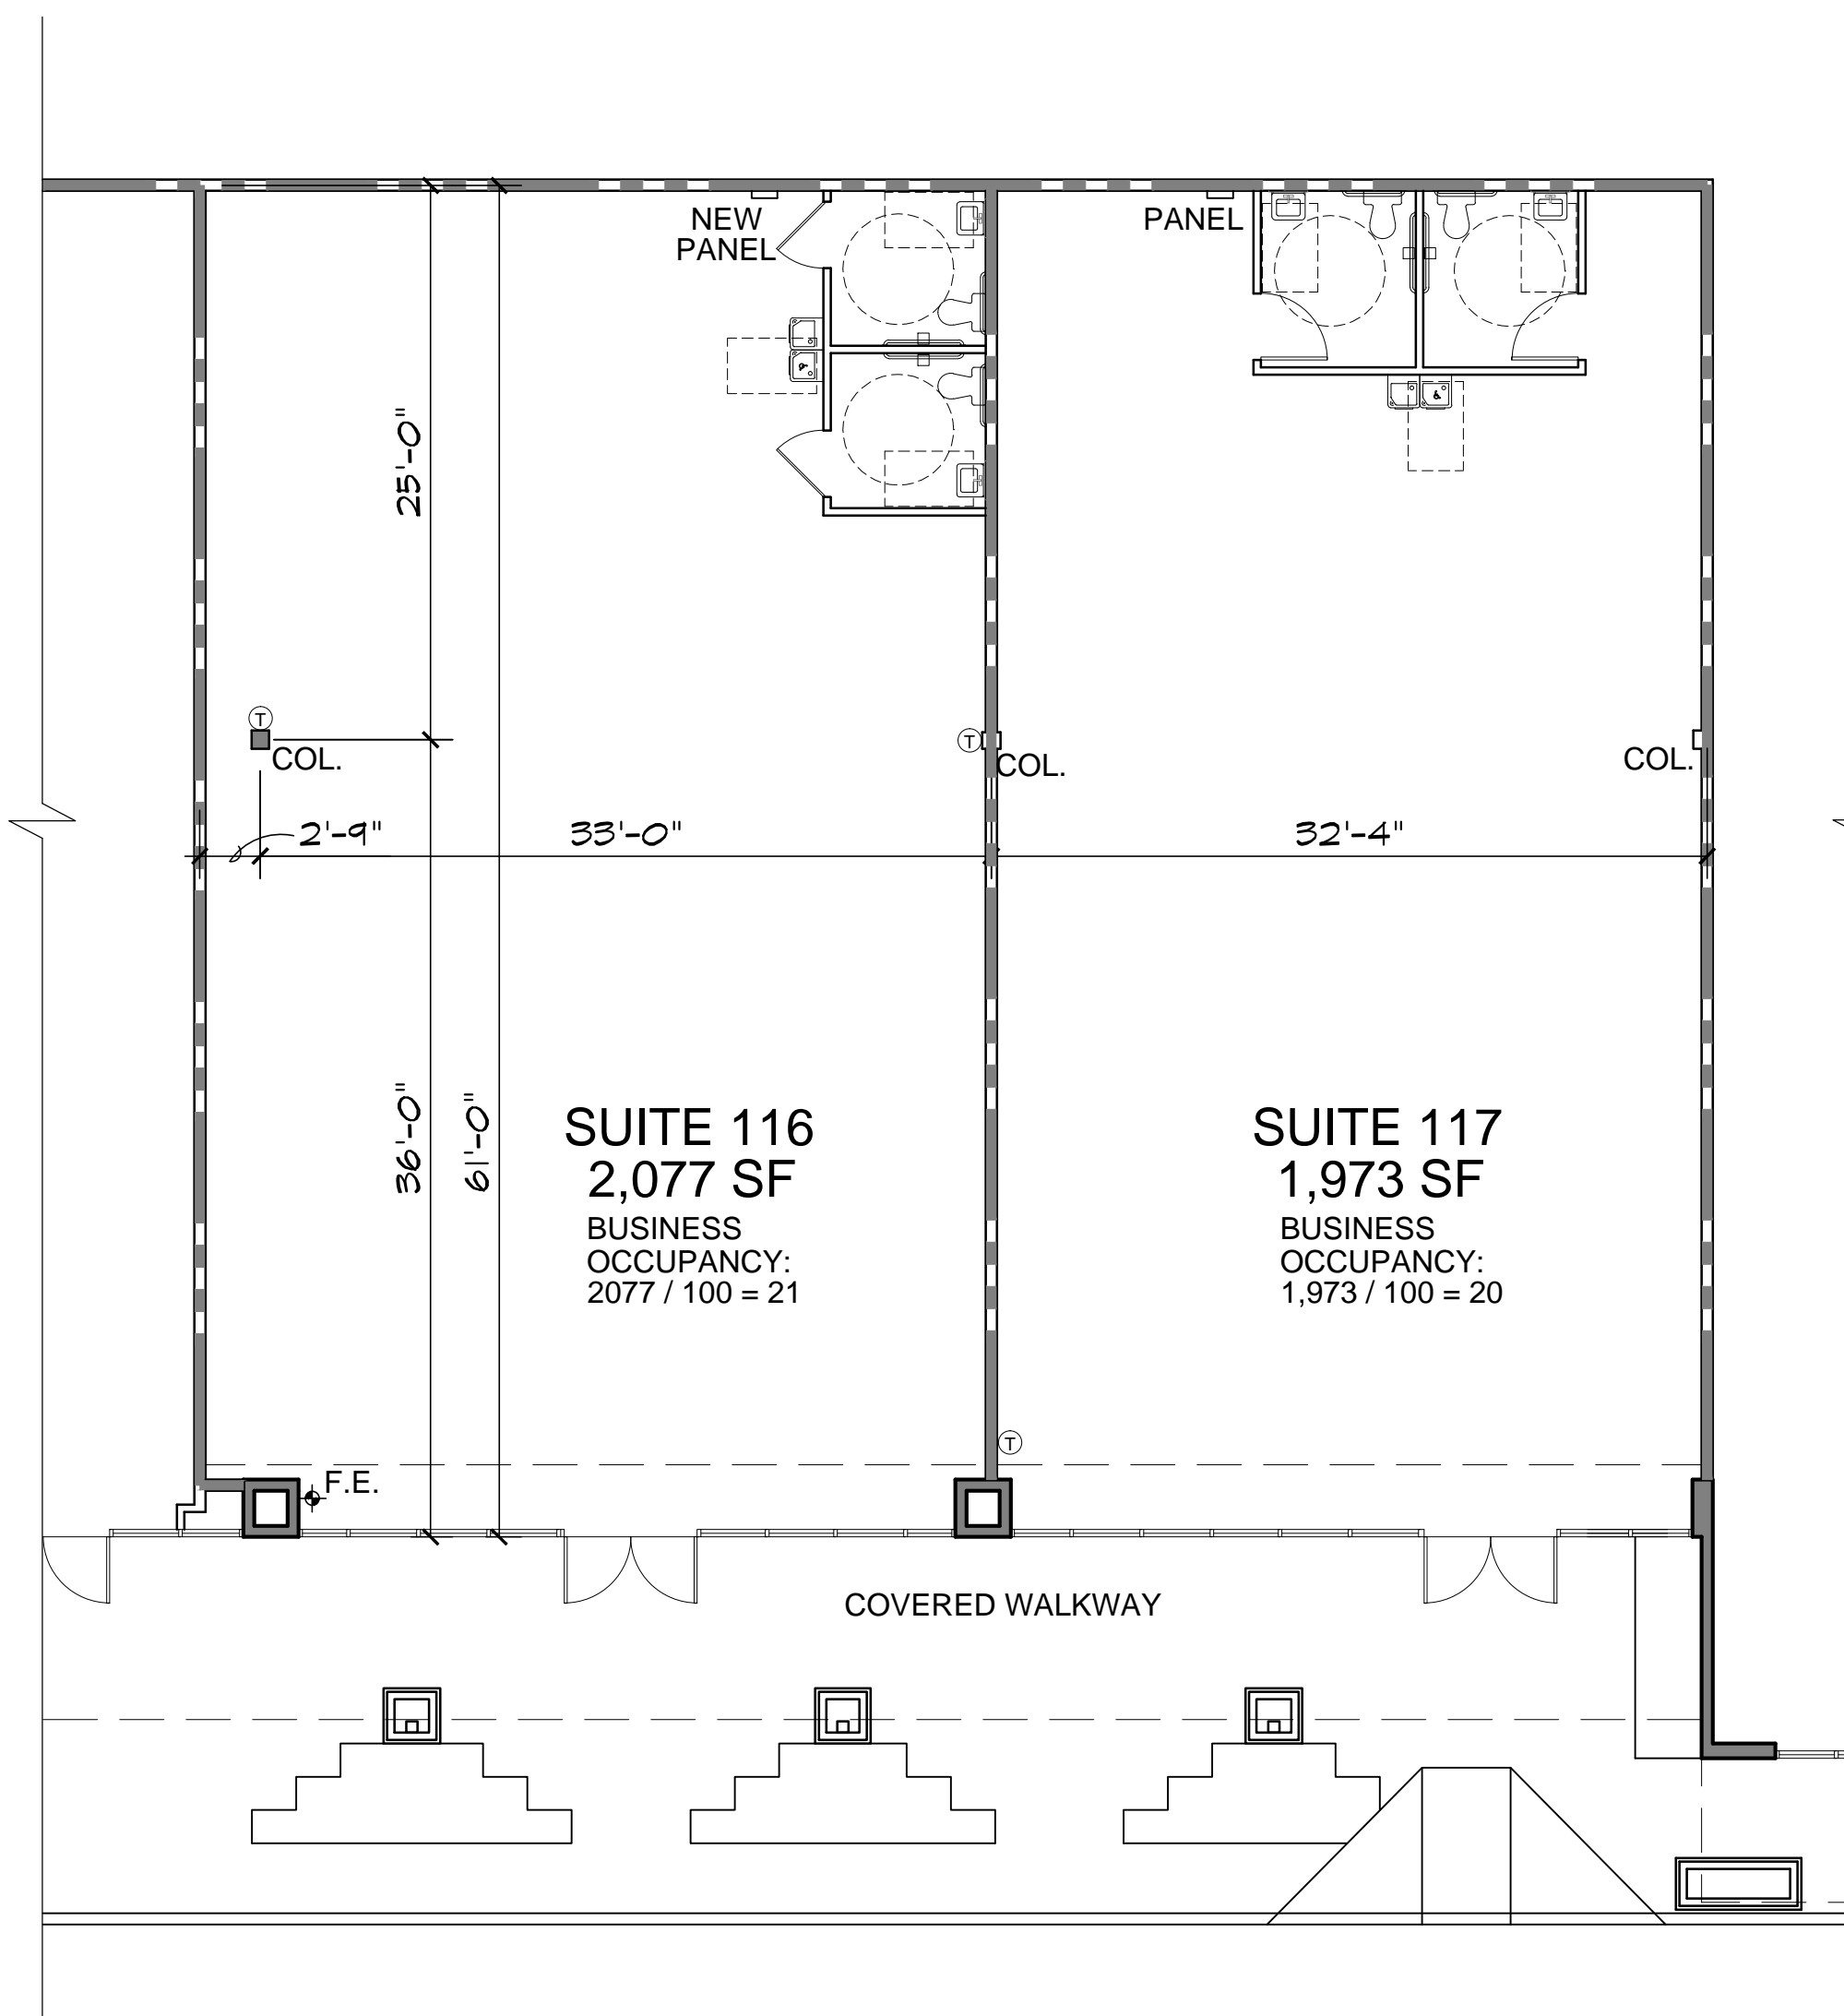

PROPOSED FLOOR PLAN
 1/8" = 1'-0"

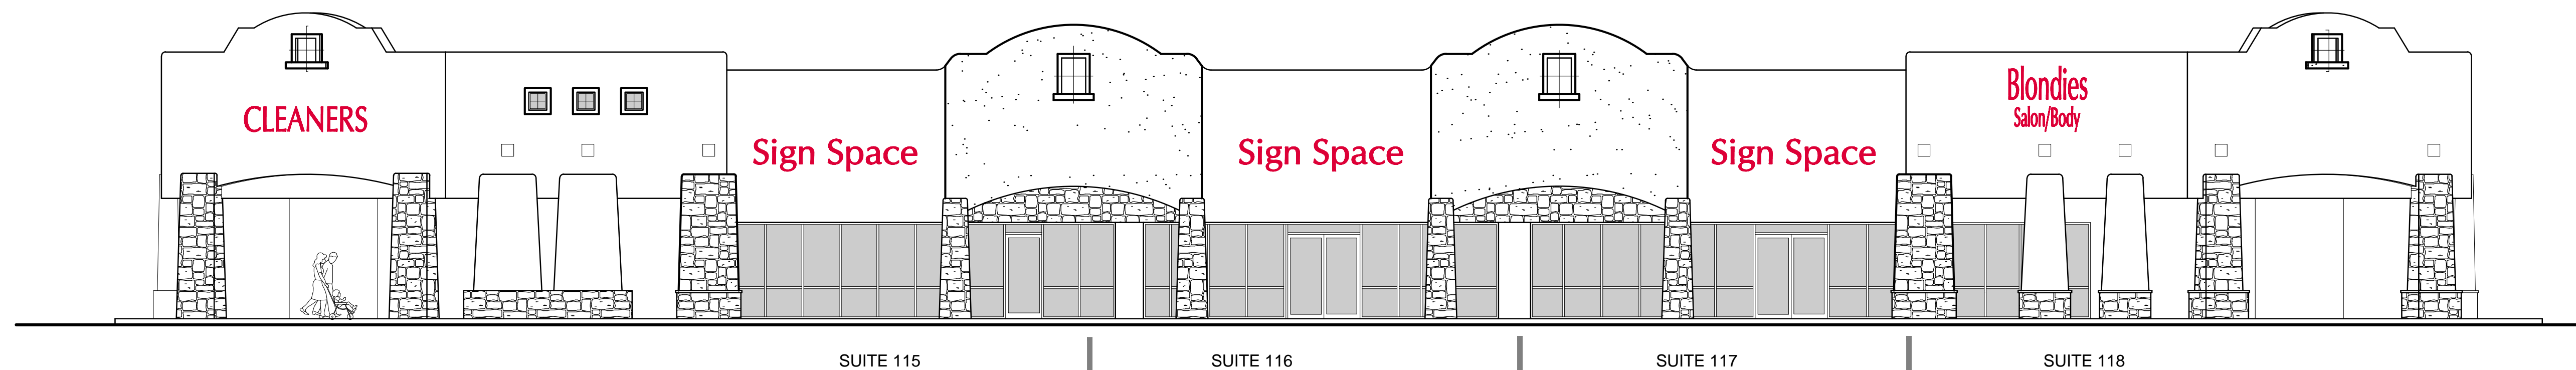

ELEVATION
 1/8" = 1'-0"

10-321 Layout DWG This drawing is an instrument of service and the property of NOTCH ENTERPRISES, LLC. The use of this drawing shall be restricted to the original site for which it was prepared.

This drawing is NOT TO BE SCALED.